



ADDENDUM NUMBER TWO – JUNE 17, 2021

Metropolitan Park District of the Toledo Area
6101 Fallen Timbers Lane
Maumee OH 43537

PROJECT: **Metroparks Toledo – Swan Creek Connector Trail, 4301
Airport Hwy., Toledo, Ohio 43615 – PID 107469**

BID DUE DATE: **UNCHANGED** – FRIDAY, JULY 02, 2021, 12 PM LOCAL TIME

Metroparks of the Toledo Area would like to issue Addendum #2 related to the above indicated project.

The following items to be changed in the bid documents shall hereinafter become part thereof and shall supersede all other specifications wherein there may be a conflict. The contractor shall perform all work in connection with said items or change as required to integrate the change with all related work under this project bid specification in a manner as to maintain the project schedule of and the continuity of quality work.

GENERAL:

Item No. 1: CLARIFICATION

Question: *Please provide further detail of the transition from the lookout to the start of the boardwalk at Pier #3. Section F-F on sheet S8 is not representative of the joint. The boardwalk is on a skew from the lookout. Should this be a cast in place diaphragm? If will have to make custom forms for the 4 beams at this location.*

Response: Sheet S8 has been revised to show more detail. Section F-F has been revised to reflect the skew, as well as an additional detail added on S8. The area in question is to be cast in place concrete. The beam ends are to be normal, i.e. no skew.

Item No. 2: CLARIFICATION

Question: *TrueNorth Steel – Bridge has begun preparing a quote for the bridge on the Metroparks Toledo - Swan Creek Connector Trail project in Toledo, OH and we have a question on the design load rating. On Page 52 of the plans says H15 and Page 54 says vehicular load of 5kips, please let us know which design load we are supposed to use in designing the bridge.*

Response: 5 kips is the minimum design load. Plan Sheet S1 has been revised to show this.

Item No. 3: CHANGE

Comment: Art Thureson, Inc. is hereby granted pre-approval as a bridge manufacturer (per the Sheet S3 2.3 Plan Note).



ADDENDUM NUMBER TWO – CONTINUED – JUNE 17, 2021

Item No. 4: CLARIFICATION

Question: *Will lane closures be allowed on both Airport Highway and Byrne Road for access to the project? If so, what will the restrictions be?*

Response: Yes. City of Toledo ordinances will apply and ODOT Maintenance of Traffic Standard Drawings will apply.

Item No. 5: CLARIFICATION

Question: *Regarding clearing and grubbing: After the trees that are called out in the plans are removed, it appears there will still be overhead branches from remaining trees that will be in conflict with construction activities. Will you consider the cutting of additional branches in the clearing and grubbing item?*

Response: Yes, this will be part of clearing and grubbing.

Item No. 6: CLARIFICATION

Question: *Regarding clearing and grubbing: There appears to be down trees that will limit access and construction activities. Is the removal of these down trees included in the clearing and grubbing item?*

Response: Yes, this will be part of clearing and grubbing.

Item No. 7: CLARIFICATION

Question: *Regarding clearing and grubbing: On pages C18 & C19, there are numerous trees called out inside the 30.00' temporary access road. These will make it difficult to get material, equipment, as well as install the proposed timber matting. Will you consider the removal of these trees within the 30.00' temporary access road?*

Response: Any trees within this area AND are necessary to remove for access purposes, as corroborated by the Owner, should be removed under the clearing and grubbing item.

Item No. 8: CLARIFICATION

Question: *The limits for the temporary causeway are unclear. Could you clarify the limits of the temporary causeway into Swan Creek?*

Response: The causeway is limited environmentally and is meant to extend to the centerline/flowline (elevation 578.80) of Swan Creek from the bank at elevation 583.00, which is ordinary high water.

Item No. 9: CLARIFICATION

Question: *The typical sections on page C3 call out the excavation, embankment, and seeding and mulching as "work to be done by Toledo Area Metroparks". These are also bid items with estimated quantities for these items. Could you clarify whether the Toledo Area Metroparks or the contractor is to do this work?*

Response: All excavation and Embankment will be performed by the contractor. Seeding along the trail will be performed by Metroparks Toledo.



ADDENDUM NUMBER TWO – CONTINUED – JUNE 17, 2021

Item No. 10: INFORMATIONAL

The current project Plan-Holder List is attached herein.

Item No. 11: INFORMATIONAL

Bidder inquiries will not be addressed after 12:00 pm Friday, June 25, 2021 in order to maintain the bid due date of Friday, July 2, 2021, 12 PM Local Time.

Attachments:



- Revised Plan Sheet S1
- Revised Plan Sheet S8
- Current Plan-Holder's List

Jon Zvanovec
Project Manager
The Metropolitan Park District of the Toledo Area

END OF ADDENDUM NUMBER TWO, JUNE 17, 2021

NOTE: Bidders must acknowledge receipt of this Addendum on the proposal form.

PLOTTED: Jun 17, 2021 -- 8:31am
 DRAWING: M:\18147 (Metroparks - Swan Creek Connector Trail)\STRUCTURAL\DWG\18147_ST.dwg: S01 P&P SWAN

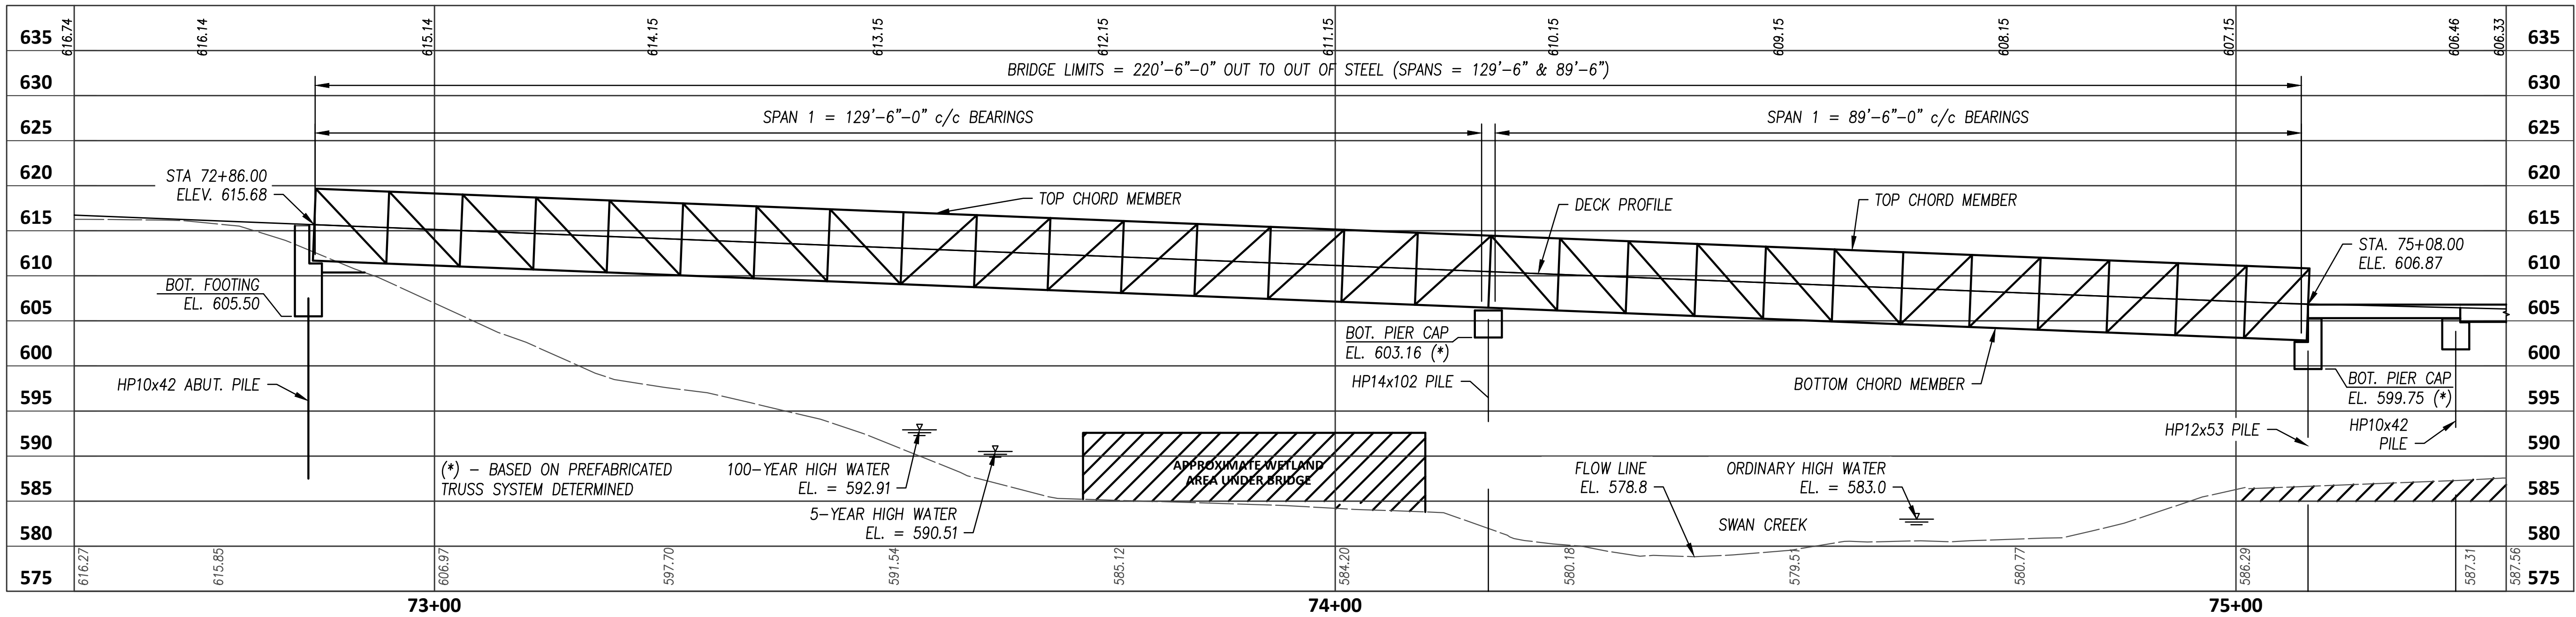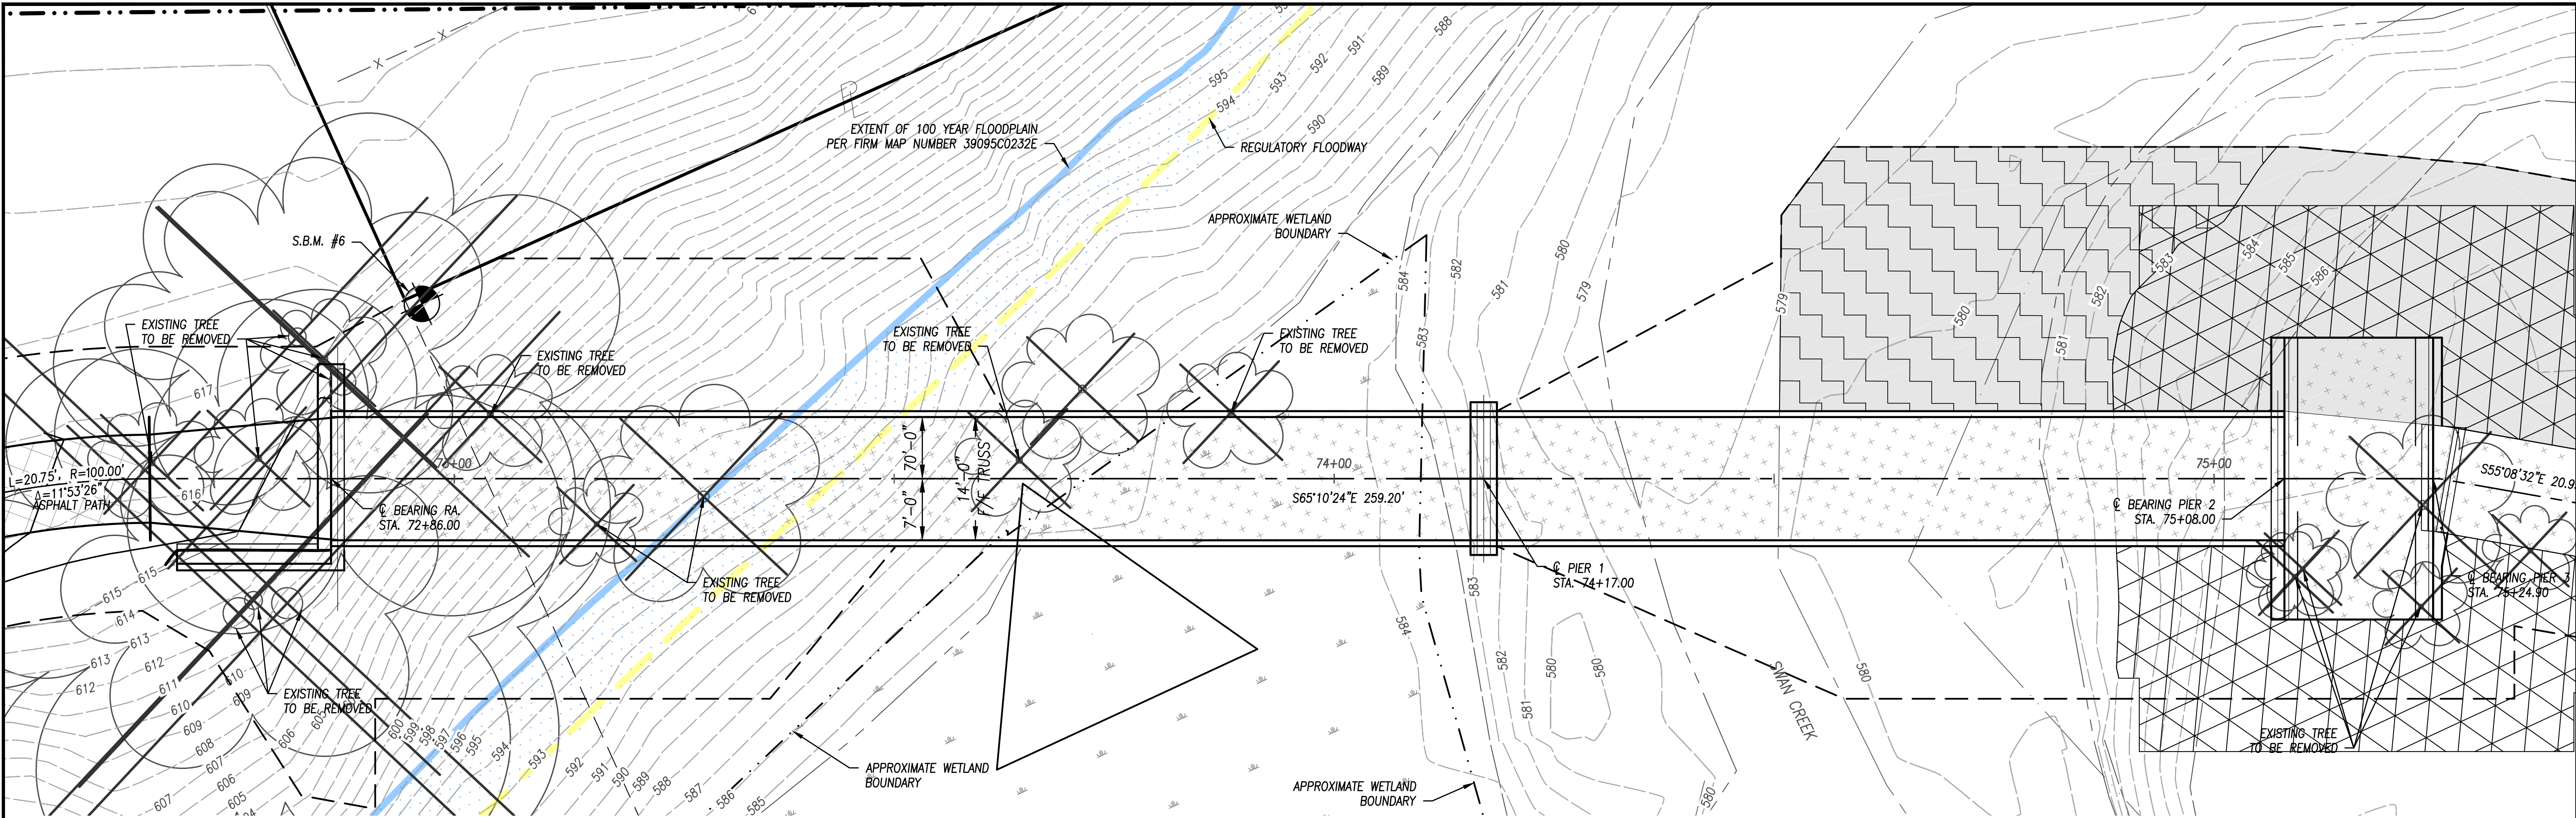

NO	REVISION	DATE
1	FOR CONSTRUCTION	02-27-20
2	ADDENDUM 2	06-17-21

DGL CONSULTING ENGINEERS, LLC
 3455 BRIARFIELD BLVD, SUITE E
 MAUMEE, OH 43537
 PHONE: 419.535.1015
 www.dgl-td.com


METROPARKS TOLEDO
SWAN CREEK CONNECTOR TRAIL
 4301 AIRPORT HWY
 TOLEDO, OHIO 43615
 LUCAS COUNTY

GENERAL PLAN & PROFILE


FILE: 18147 ST.dwg
JOB NO.: 18147
DRAWN BY: X
ISSUED: FEB 27, 2020

S1

PLOTTED: Jun 16, 2021 - 3:24pm
DRAWING: M:\18147 (Metroparks - Swan Creek Connector Trail)\STRUCTURAL\Draw\18147 SD.dwg: S8 LOOKOUT DETAILS

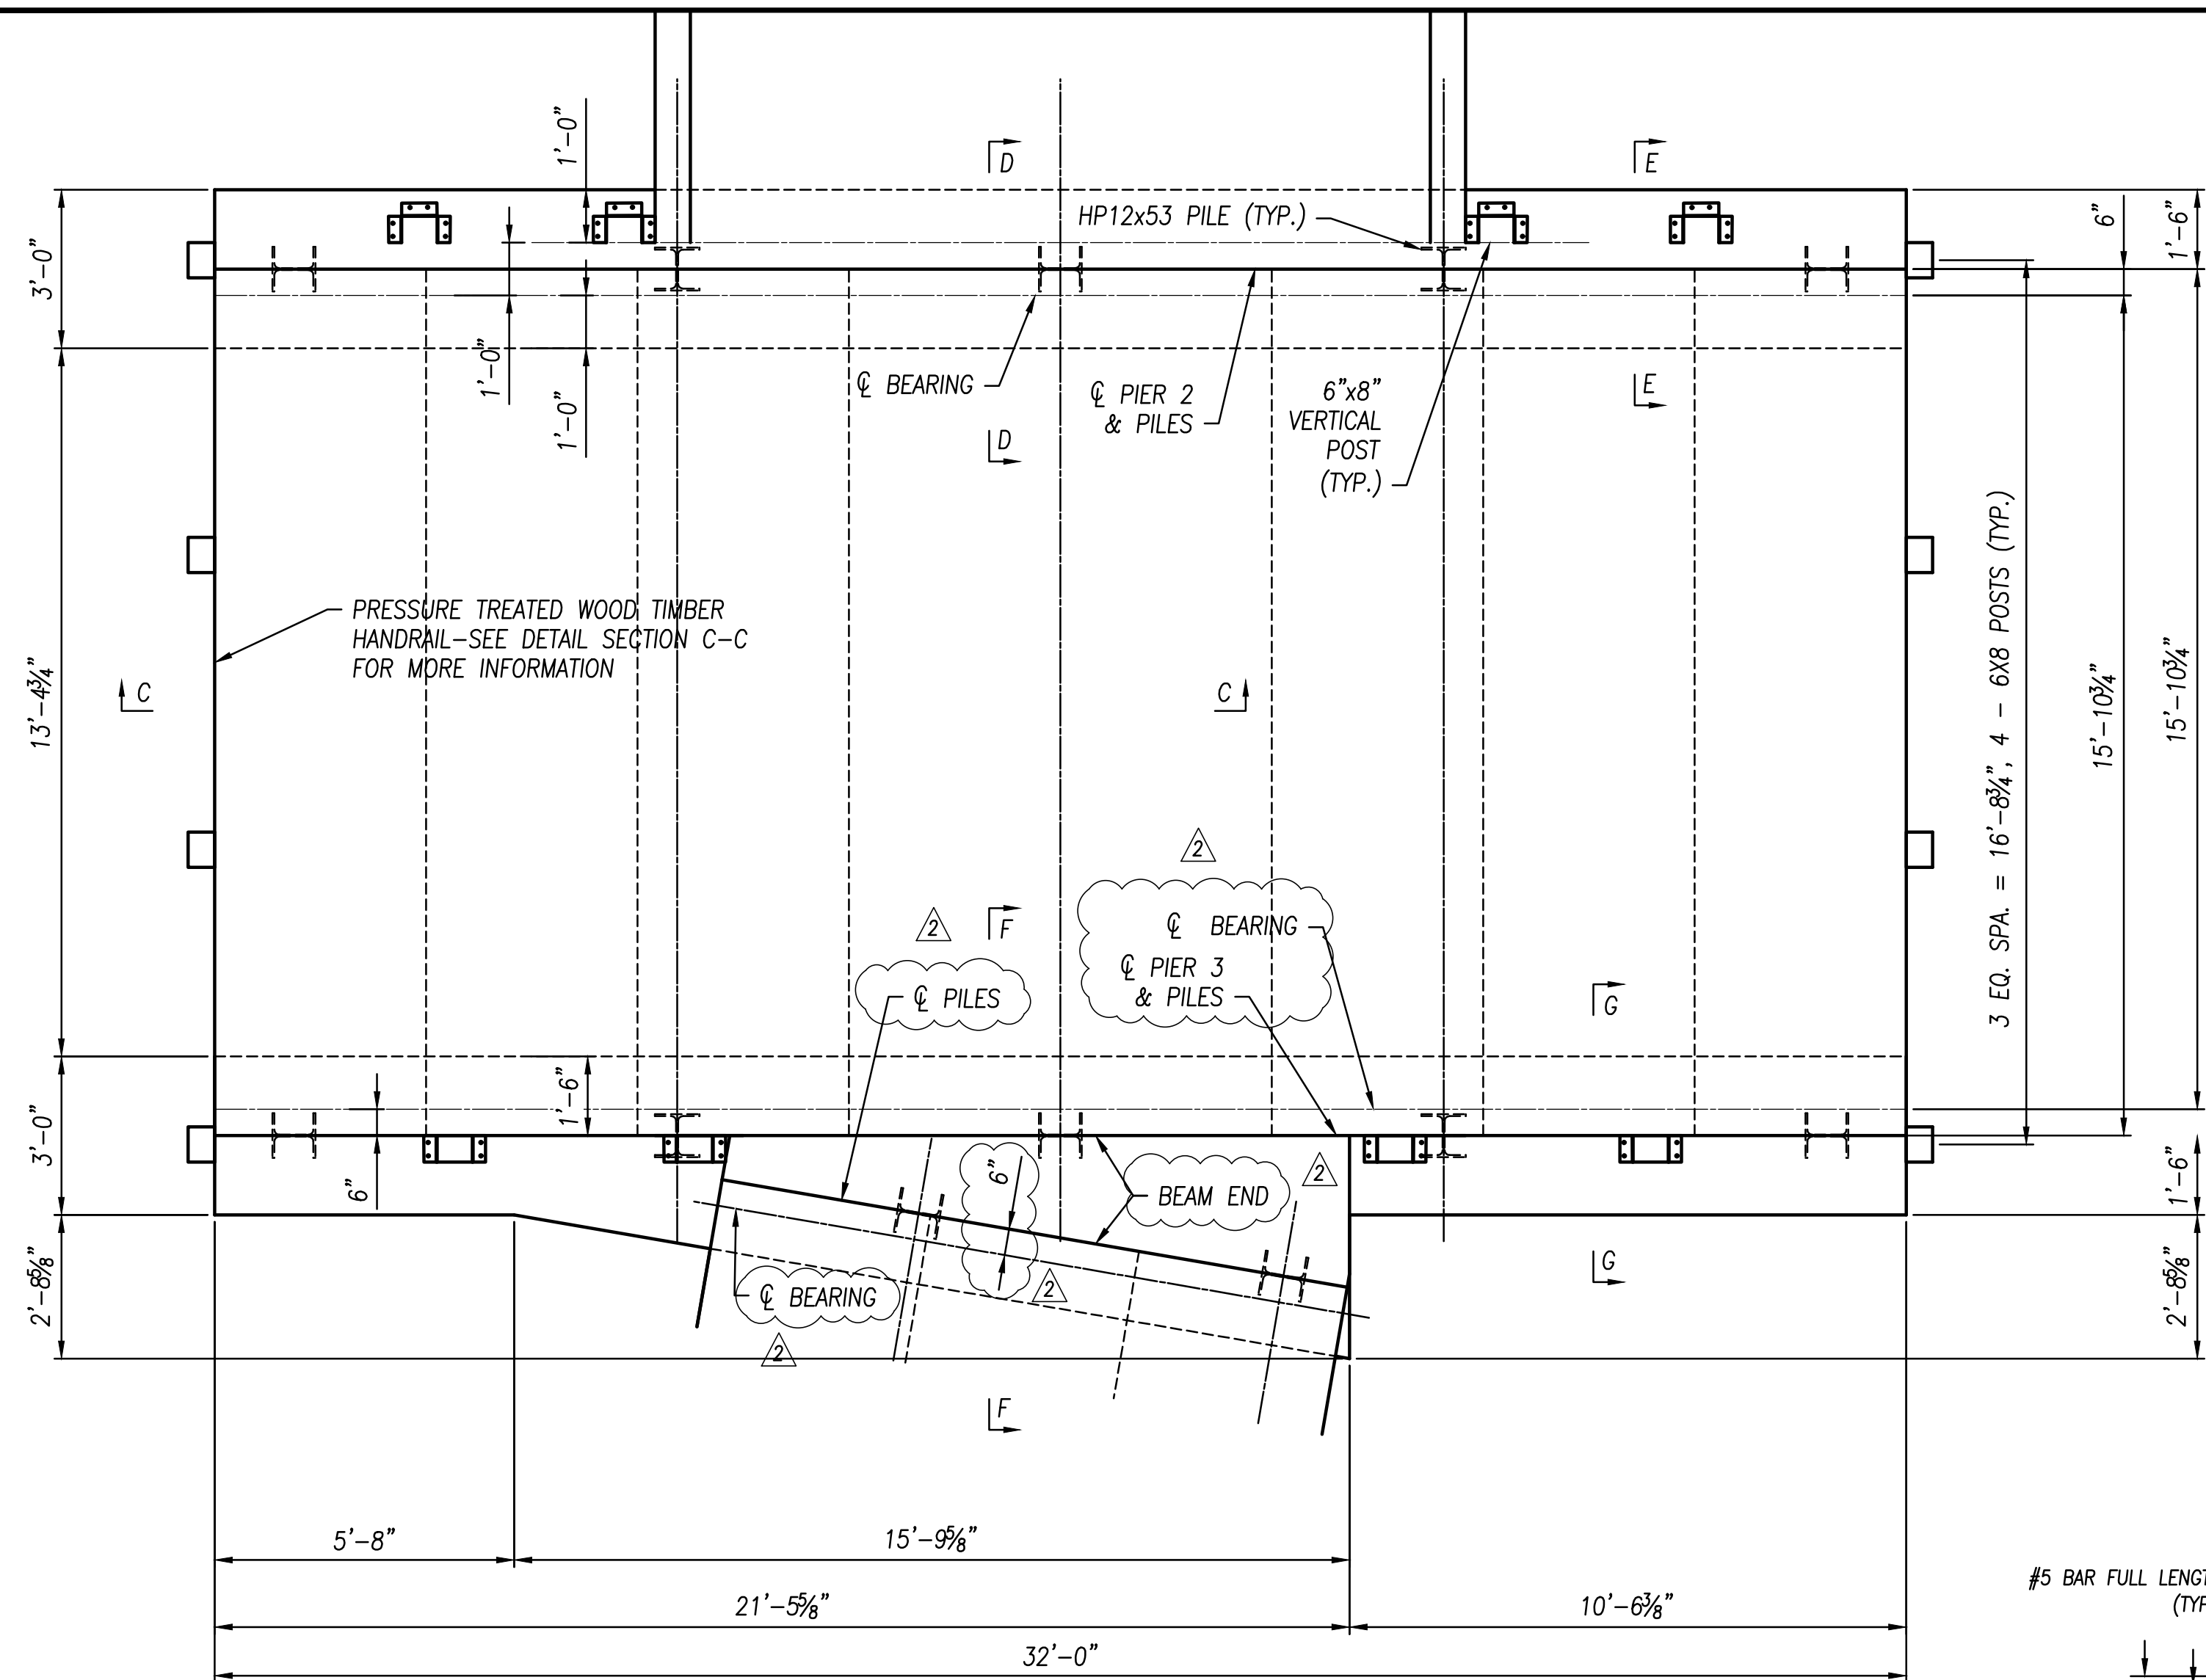


LOOKOUT PLAN

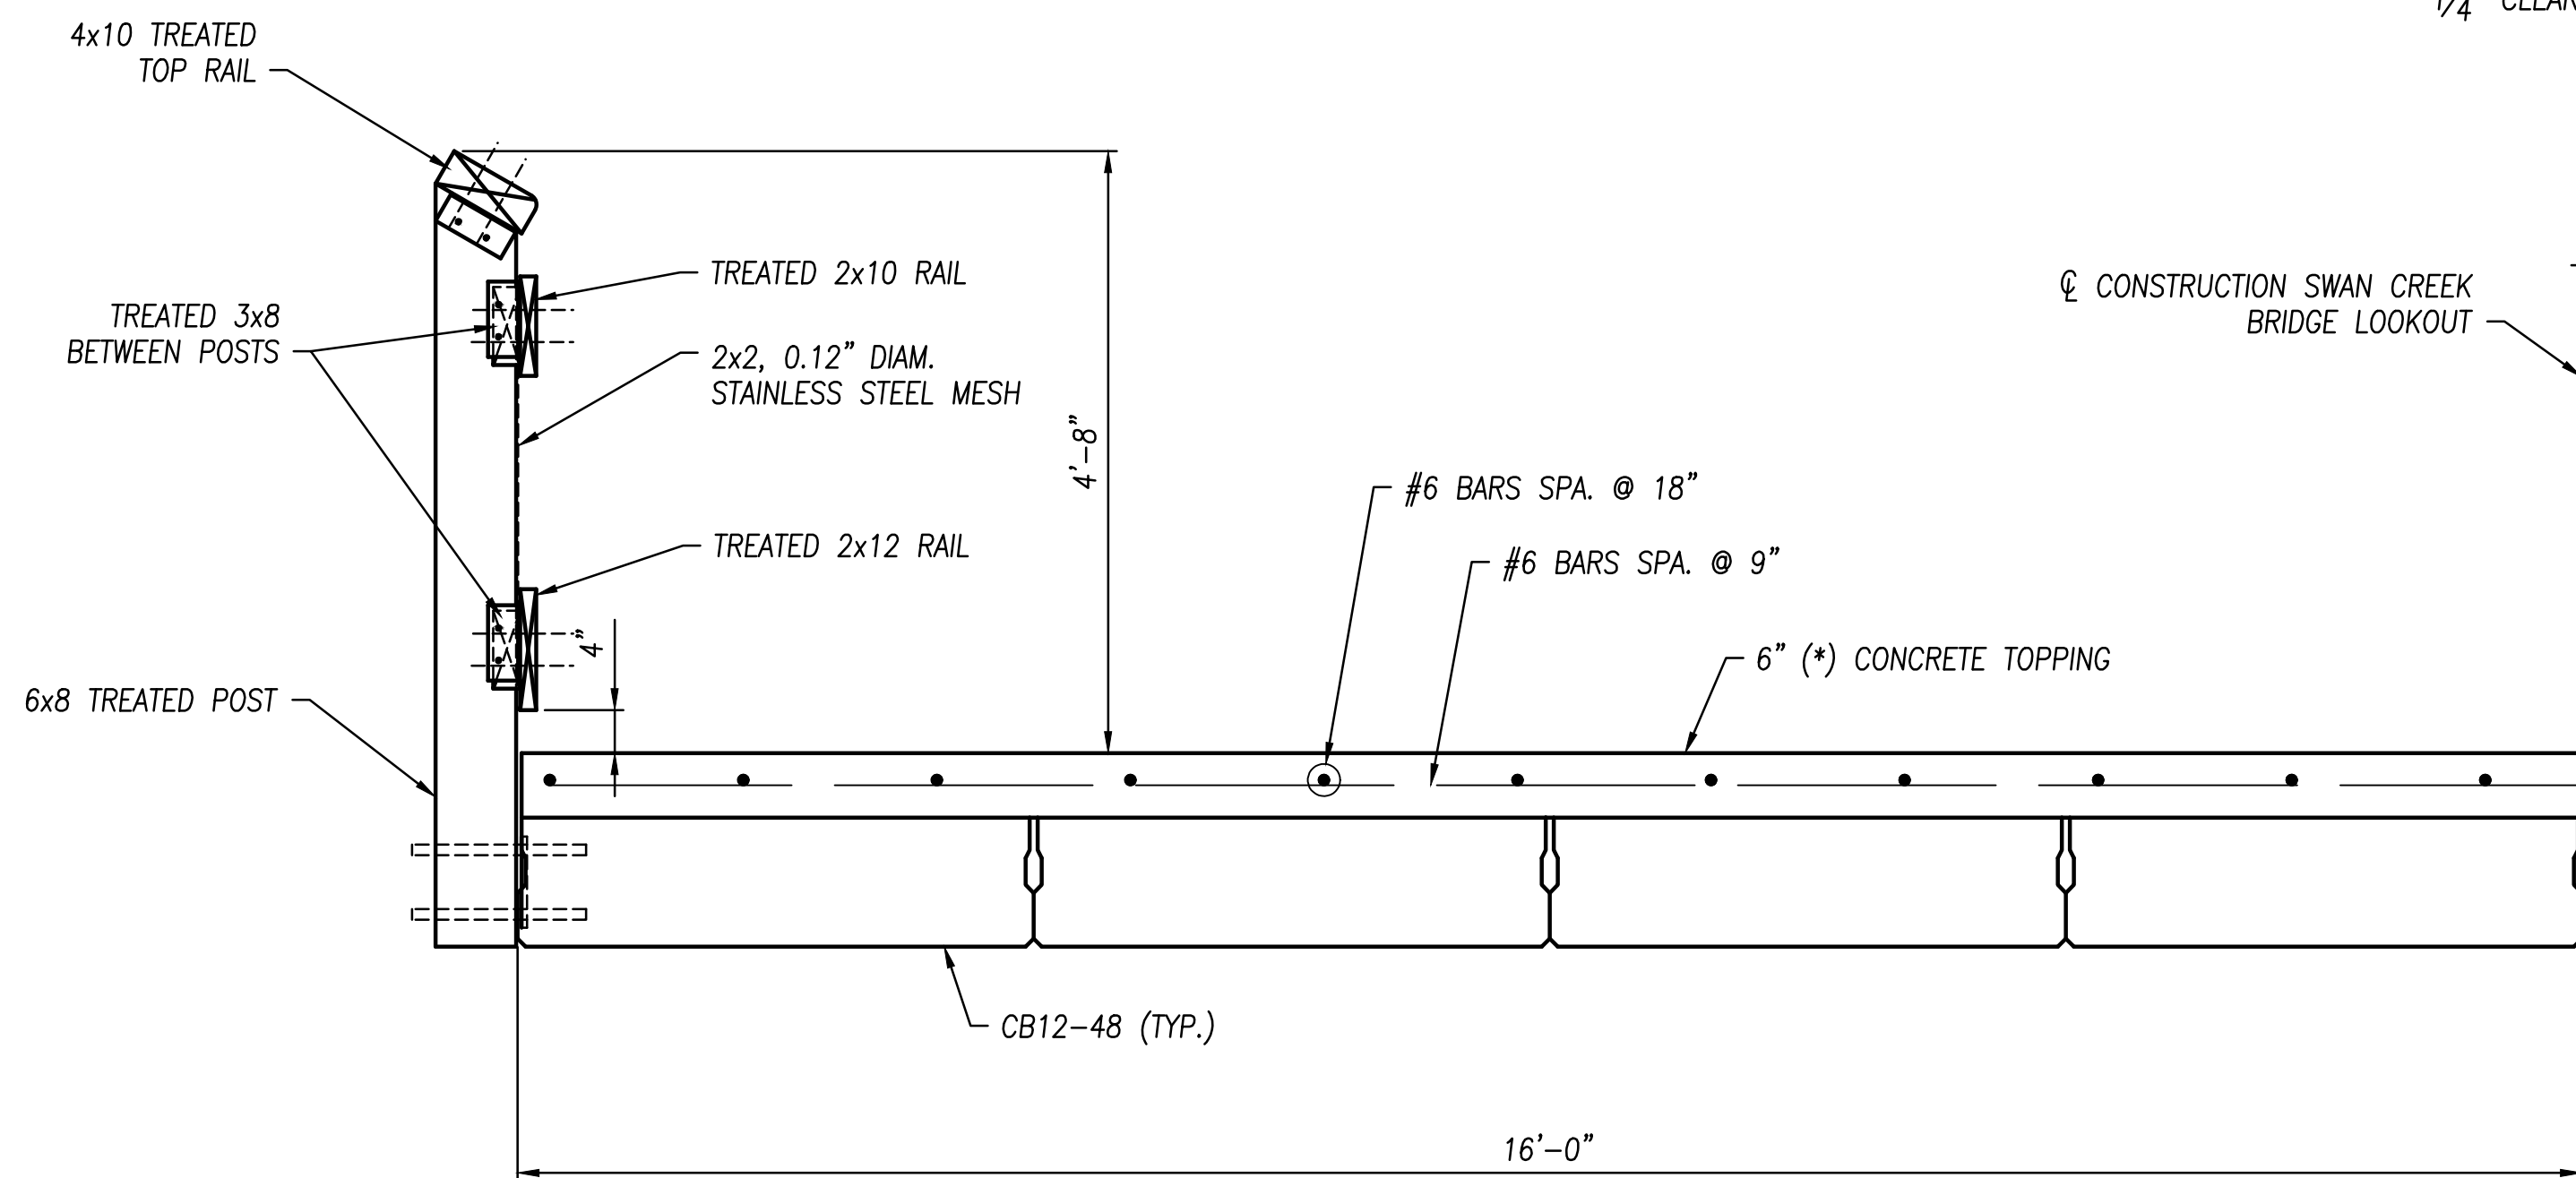


SECTION C-C

(*) - PLACE 6" CONCRETE AT EACH BEAM END, TRANSITION TO 6" DEPTH AT MID-SPAN

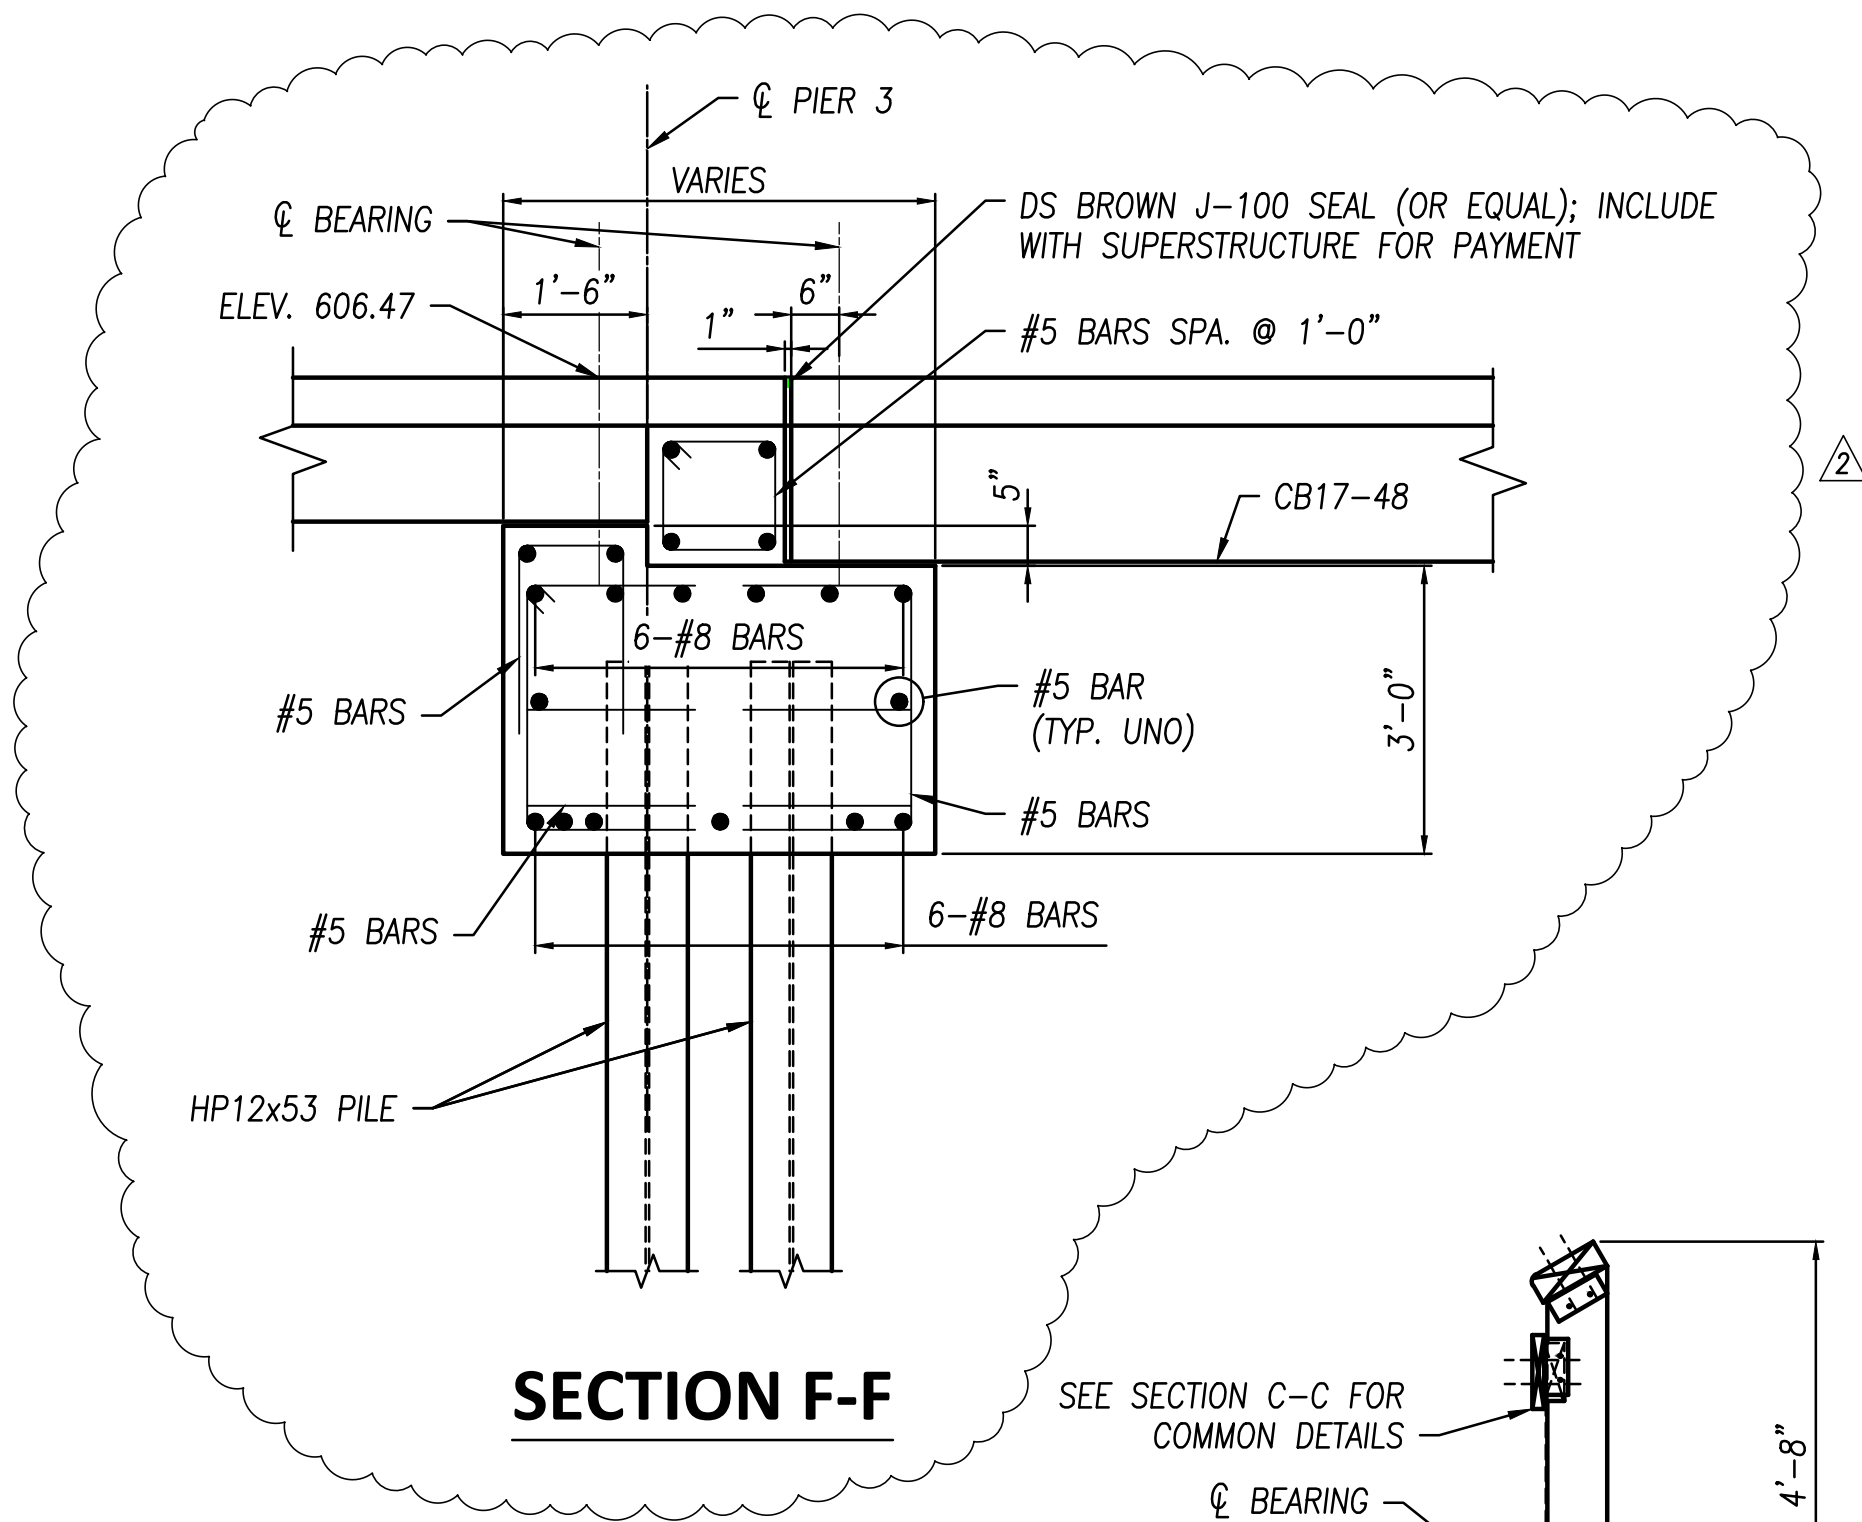


SECTION F-F

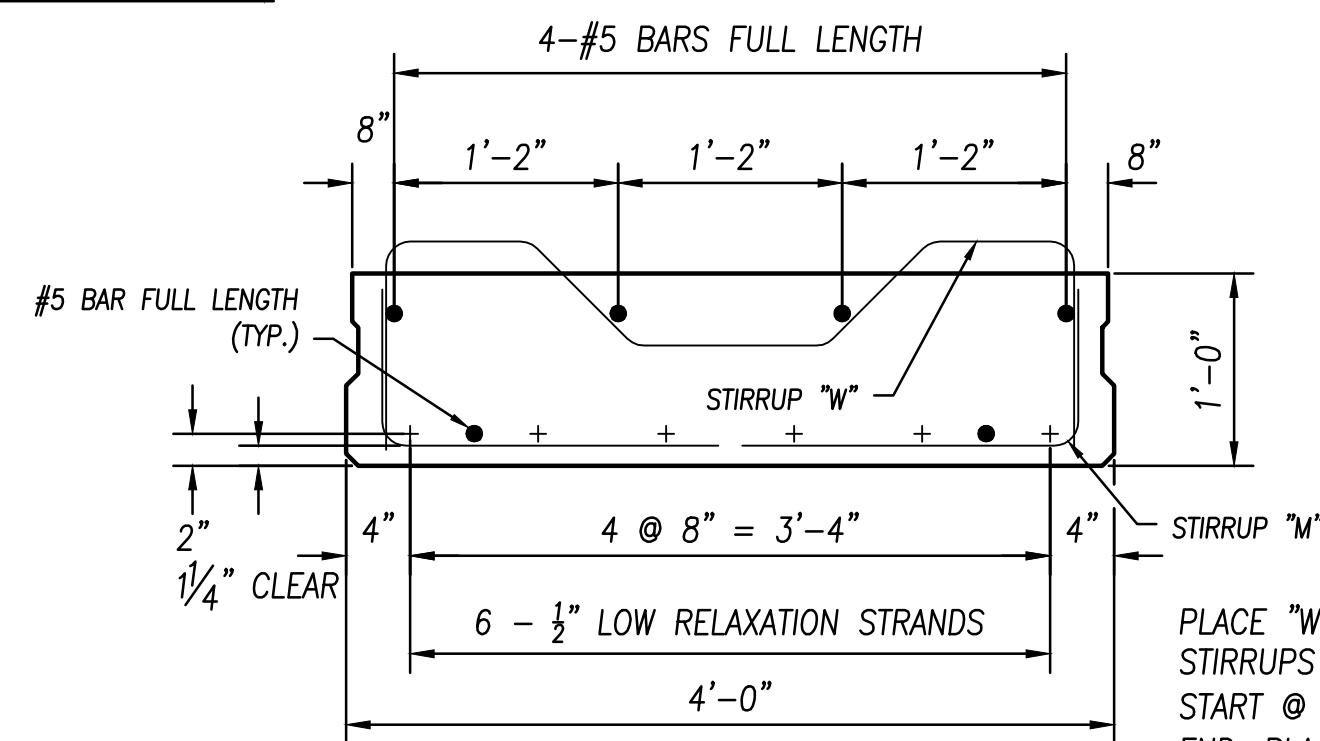


**BEAM SECTION (CB12-48)
(SPAN 3)**

PLACE "W" & "M" STIRRUPS TOGETHER. START @ 4" FROM EACH END. PLACE 4 AT 3" SPACING (EACH END). PLACE BOTH TOGETHER IN BETWEEN AT 10" (MAX.) SPACING.

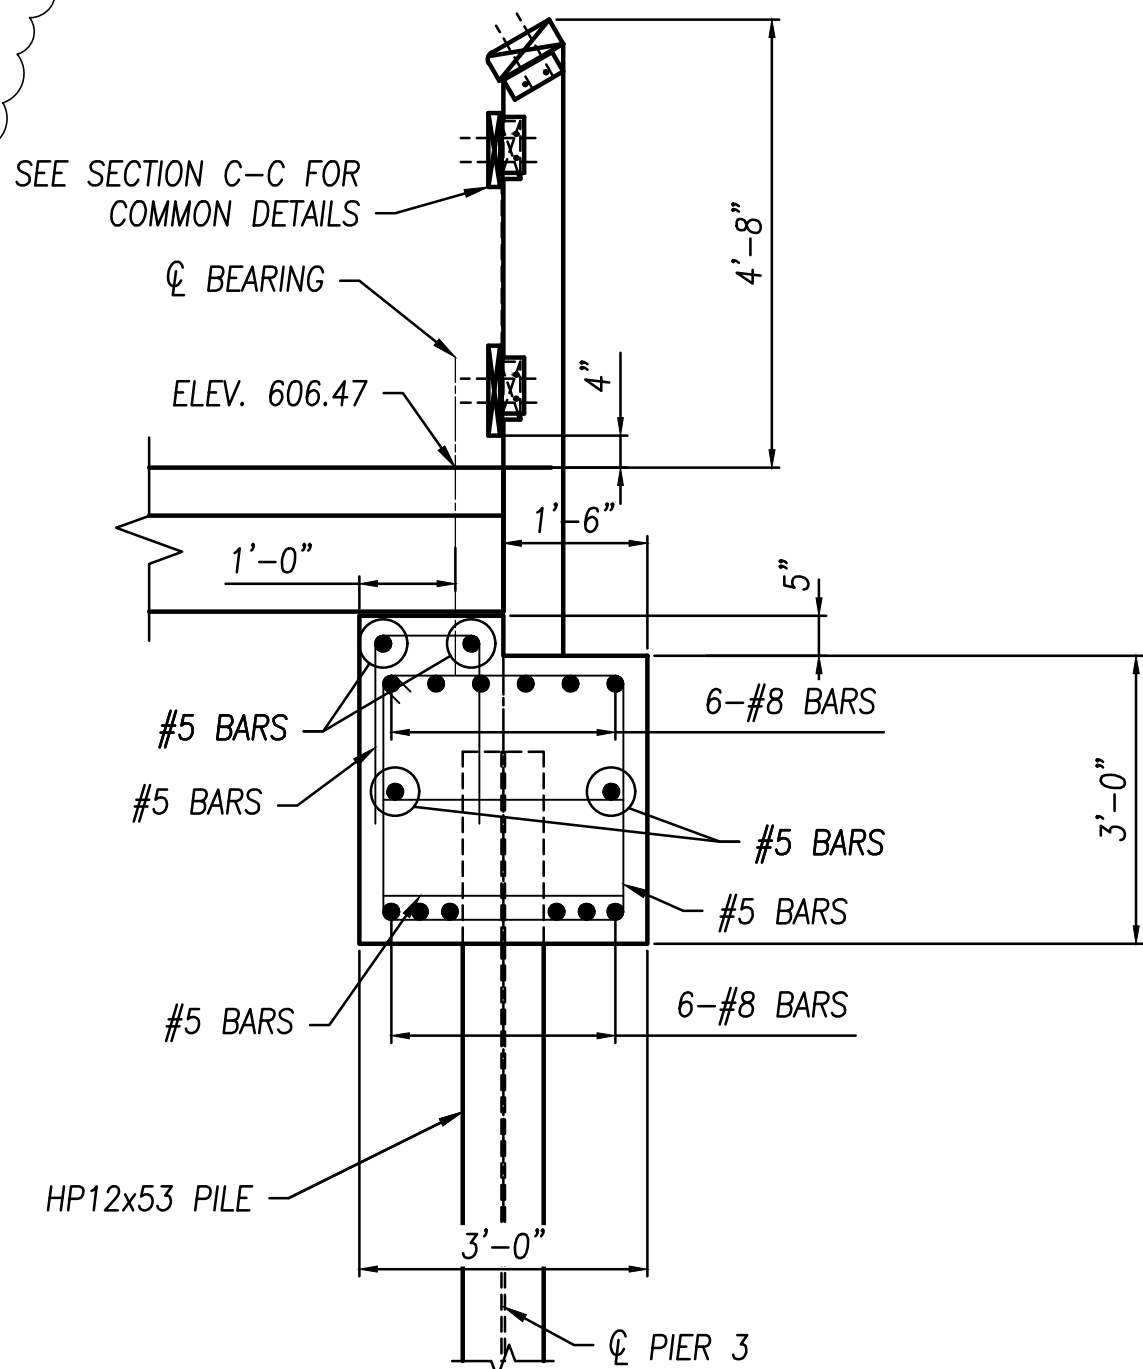

SECTION G-G

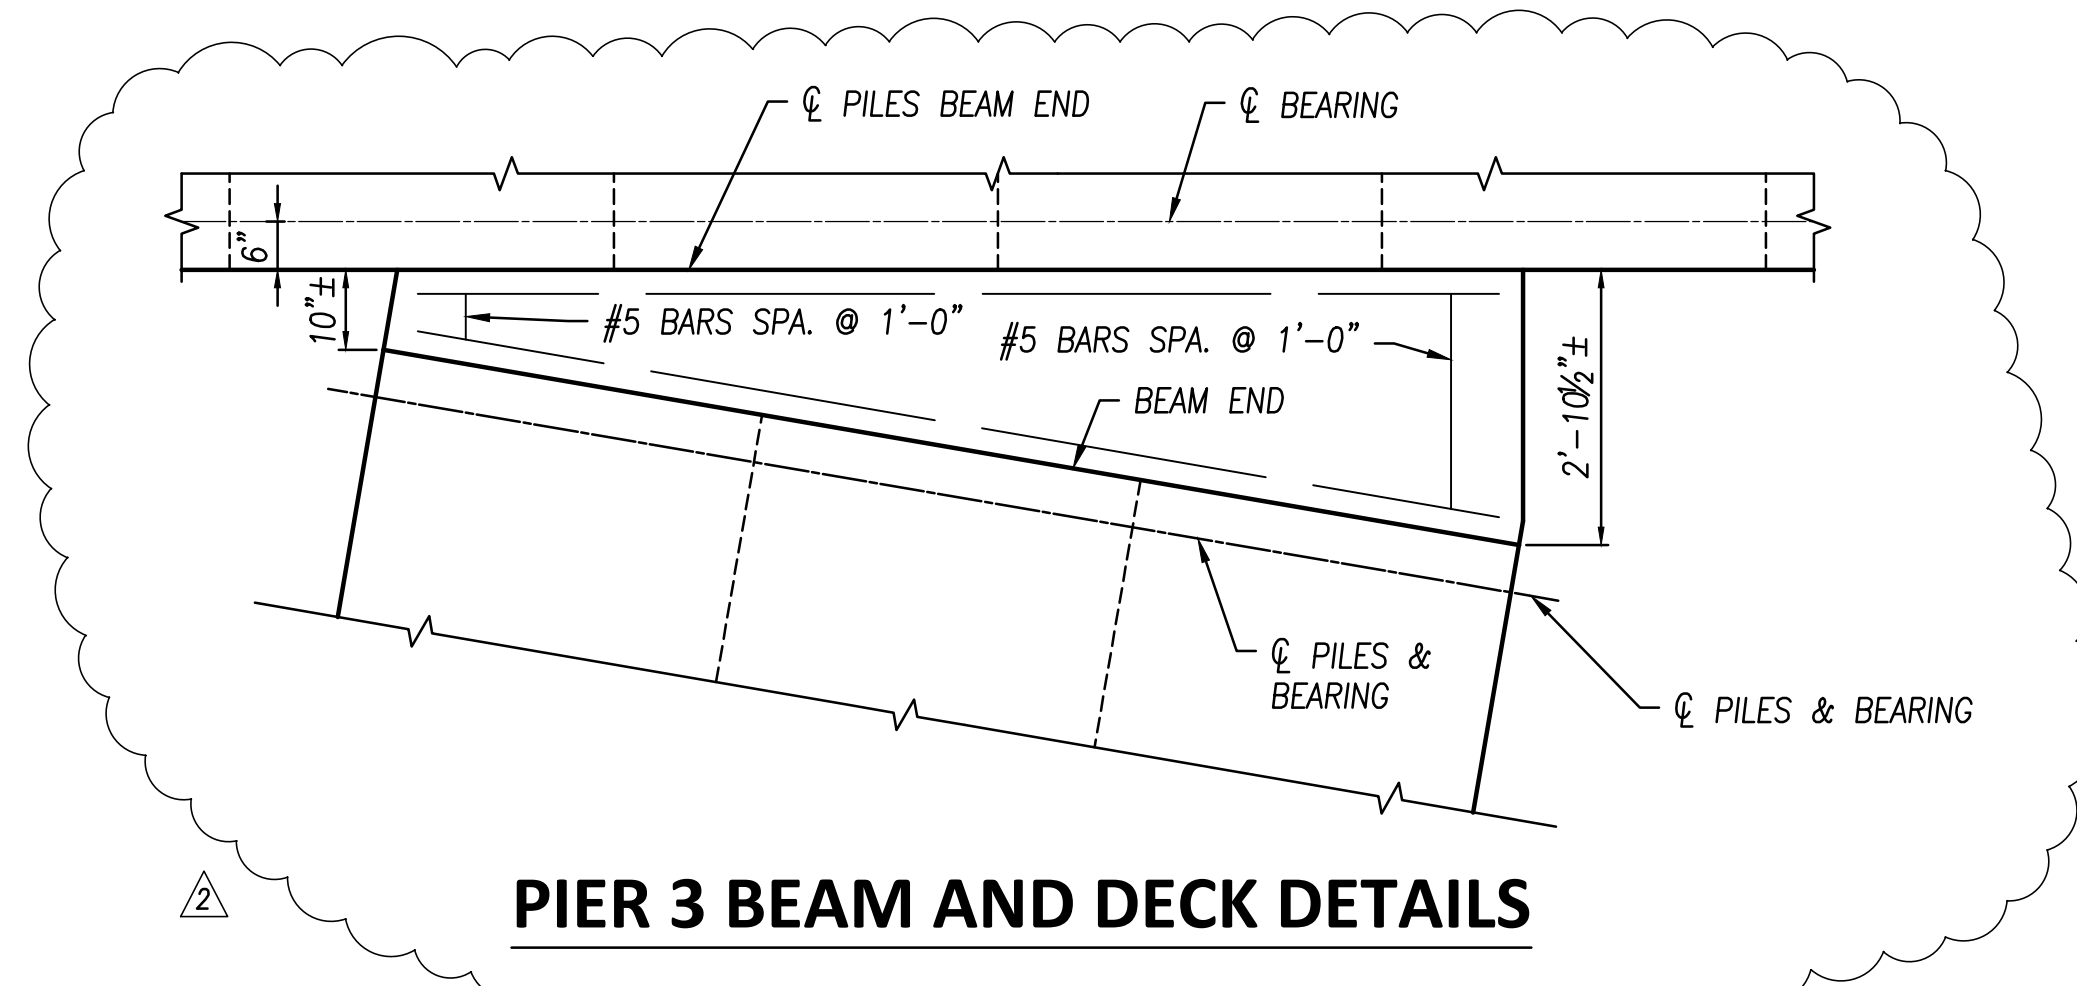

PIER 3 BEAM AND DECK DETAILS



NO	REVISION	DATE
1	FOR CONSTRUCTION	02-27-20
2	ADDENDUM 2	06-16-21



**METROPARKS TOLEDO
SWAN CREEK CONNECTOR TRAIL**
4301 AIRPORT HWY
TOLEDO, OHIO 43615
LUCAS COUNTY

LOOKOUT PLAN AND DETAILS

FILE: 18147 SD.dwg
JOB NO.: 18147
DRAWN BY: SAH
ISSUED: FEB 27, 2020

S8

**Metroparks Toledo – LUC - Swan Creek Corridor Trail, 4301 Airport Hwy.,
Toledo, Ohio 43615 – PID 107469**

Bid Opening Friday, July 02, 2021, 12:00 pm Local Time, Fallen Timbers Field Office

PLAN-HOLDER'S LIST

COMPANY NAME	DISCIPLINE	PHONE	EMAIL	CONTACT NAME	ADDRESS
E.S.Wagner Co	General Contractor	419-467-3208	qlawrence@eswagner.com	Quinn Lawrence	840 Patchen Road, Oregon, OH 43616
Mosser Construction, Inc.	General Contractor	419-861-5100	mahten@mossergrp.com	Michael A. Ahten	1613 Henthorne Dr, Maumee, OH 43537
Anderzsch Pitzen Construction, Inc.	General Contractor	419-644-2111	marynicholas@wecandigit.com	Mary Nicholas	424 E Main St, Metamora, OH 43540
The Delventhal Company	General Contractor	419-244-5570	cathy@thedelventhalco.com	Cathy Permar	3796 Rockland Circle, Millbury, OH 43447
George Gradel Co,	Sitework	419-691-7123	estimating@geogradelco.com	Frederick Sander	3135 Front St., Toledo, OH 43605
Miller Bros. Const., Inc.	General Contractor	419-445-1015	estimating@mbcholdings.com	Jeremy Hurst	1613 S Defiance St, PO Box 30, Archbold, OH 43502
AA Boos & Sons	General Contractor	419-691-2329	staciewilburn@aaboos.com	Stacie Wilburn	2015 Pickle Rd, Oregon, OH 43616
Rudolph Libbe, Inc.	General Contractor	419-725-3284	mdean@rlcos.com	Michelle Dean	6494 Latcha Road Walbridge, OH 43465- 9738
Kokosing Construction Co. Inc.	General Contractor	614-228-1029 419-565-5858	mck2@kokosing.biz	M. Cody Kerr	6235 Westerville Rd., Westerville, OH 43081
Geddis Paving & Excavating, Inc.	Paving & Excavating	419-536-8501	pmunson@geddispaving.com	Petra Munson	1019 Wamba Ave. Toledo, OH 43607
Vernon Nagel, Inc.	General Contractor	419-592-3861	estimates@nagelinc.com	Marc Nagel	0154 County Rd. 11C Napoleon, OH 43545
The Spieker Co.	General Contractor	419-872-7000	santanna@office.spiekercompany.com	Aaron White	2541 Tracy Rd. Northwood, OH 43619
Rietschlin Construction Inc	General Contractor	419-347-4241	meg@rietsclinconstructionoh.com	Margaret Rietschlin	4240 Baker Rd Crestline, OH 44827
B&J Concrete & Construction Co	General Contractor	419-966-7907	kevin.bjconcrete@sbcglobal.net	Kevin McCulley	5840 Secor Rd Toledo, OH 43623
Expercon, LLC	General Contractor	419-214-4343	rb2@expercon.biz	Rob Bischoff	1 Maritime Plaza, Toledo, OH 43604
Miller Diversified	General Contractor	419-867-9119	npearson@millerdiversified.com	Nate Pearson	1656 Henthorne Drive, Suite 100 Maumee, OH 43537
TrueNorth Steel - Bridge	Drainage & Modular Bridge Supplier	605-870-0627	Kaiti.LaVoy@TrueNorthSteel.com	Kaiti Lavoy	702 13th Ave. E West Fargo, ND 58078
American Timber and Steel	Steel & Timber Material Supplier	419-668-1610	jacqui@amtim.com	Jacqui Gross	4832 Plank Road PO Box 767 Norwalk, OH 44857
Norwalk Concrete Industries	Precast Manufacturer	800.733.3624	chip@nciprecast.com	Chip Brown	80 Commerce Drive Norwalk, OH 44857